

Bent
5745

OWNER: A. E. Albertsen

MAILING ADDRESS:


LOCATION OF WELL: Owner's No.

CITY AND STATE:

Philomath

NE 1/4 NW 1/4 Sec. 12 T. 12 N. S., R. 6 E. W., W.M.

Bearing and distance from section or subdivision corner 930' South and 200' East from the NW Cor. 202' North and 1691' West of the SW Cor. of Isaac H. Newton DLC 37

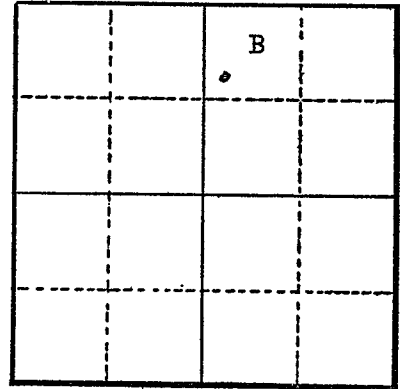

Section 12

Altitude at well 279'

TYPE OF WELL: Drilled Date Constructed August, 1949

Depth drilled 67 feet Depth cased 65 feet

CASING RECORD:

6-inch casing set to 65 feet

FINISH:

perforated casing set from 60 feet to 65 feet

AQUIFERS:

clay

WATER LEVEL:

6 feet

PUMPING EQUIPMENT: Type Myers Jet Pump H.P.

Capacity 30 G.P.M.

WELL TESTS:

Drawdown ft. after hours 30 G.P.M.

Drawdown ft. after hours G.P.M.

USE OF WATER Industrial Temp. °F. 19

SOURCE OF INFORMATION GR-4008

DRILLER or DIGGER

ADDITIONAL DATA:

Log X Water Level Measurements Chemical Analysis Aquifer Test

REMARKS:

Clay

0

67