

STATE ENGINEER
Salem, Oregon

Well Record

*Bent
5751*


STATE WELL NO. 12/6W-12P
COUNTY Benton
APPLICATION NO. GR-3330

OWNER: Earl E. Hines MAILING ADDRESS: Box 571

LOCATION OF WELL: Owner's No. _____ CITY AND STATE: Philomath, Oregon

SE 1/4 SW 1/4 Sec. 12 T. 12 S., R. 6 W., W.M.

Bearing and distance from section or subdivision
corner 1050 feet North and 150 feet West
from the S 1/4 Corner, Section 12.

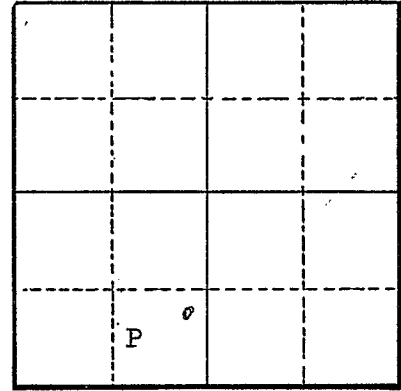

Section 12

Altitude at well 273 feet

TYPE OF WELL: Drilled Date Constructed 1944

Depth drilled 70 feet Depth cased 43 feet

CASING RECORD:

5-inch casing set from ground to 43 feet

FINISH:

AQUIFERS:

WATER LEVEL:

9 feet

PUMPING EQUIPMENT: Type Pacific Deep Well Jet H.P. _____
Capacity 20 G.P.M.

WELL TESTS:

Drawdown _____ ft. after _____ hours _____ G.P.M.
Drawdown _____ ft. after _____ hours _____ G.P.M.

USE OF WATER Irrigation Temp. _____ °F. _____, 19____

SOURCE OF INFORMATION GR-4014

DRILLER or DIGGER Morton Sargent

ADDITIONAL DATA:

Log (NA) Water Level Measurements _____ Chemical Analysis _____ Aquifer Test _____

REMARKS:

Eugene Hermansen

RECEIVED
OCT 11 1958

Philomath, Ore.

Dear Nye,

I guess I've got the description
the way you wanted it but
in case I haven't I'll send
you the legal description of
the lot on which the well is
located. The township is 12,
South Range 6 West, between
section 12 & 13.

Beginning at a point 380 ft. south of
the northwest corner of Lot 5 of Farming
Lots to Brown's Addition to Philomath,
Wenton County, Oregon; thence east, parallel
with South Street, 120 ft. to a point; thence
north, parallel with South M St., 80 ft to a
point; thence east, parallel with South Street,
120 ft. to a point; thence south, parallel
with South M street, 85 ft. to a point, thence
west, parallel with South St., 240 ft to a
point; thence north 5 ft. to the point of
beginning.