

STATE ENGINEER
Salem, Oregon

Well Record

Bent 5829 STATE WELL NO. 12/6W-15B
COUNTY BENTON
APPLICATION NO. GR-3755

OWNER: Nr. & Mrs. Stirnemann, Louis

MAILING ADDRESS: Rt 2 Box 77 Gellatly Way

LOCATION OF WELL: Owner's No. _____


CITY AND STATE: Philomath, Oregon

NW 1/4 NE 1/4 Sec. 15 T. 12 S., R. 6 W., W.M.

Bearing and distance from section or subdivision

corner 110' S & 247' W of NE cor J. L. Bounds

DLC #69

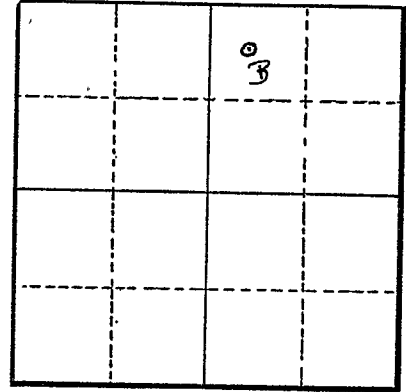

Section 15

Altitude at well _____

TYPE OF WELL: Drilled Date Constructed 1947

Depth drilled 50' Depth cased _____

CASING RECORD: _____

FINISH: _____

AQUIFERS: _____

WATER LEVEL: _____

27'

PUMPING EQUIPMENT: Type Ever-Ready-Jet

H.P. 1

Capacity 20 G.P.M.

WELL TESTS:

Drawdown _____ ft. after _____ hours _____ G.P.M.

Drawdown _____ ft. after _____ hours _____ G.P.M.

USE OF WATER Irrigation

Temp. _____ °F. _____, 19____

SOURCE OF INFORMATION GR-3960

DRILLER or DIGGER _____

ADDITIONAL DATA:

Log NA Water Level Measurements _____ Chemical Analysis _____ Aquifer Test _____

REMARKS: _____