

BENT 6176

STATE ENGINEER
Salem, Oregon

*Bent
6176*

Well Record

STATE WELL NO. 13/4W-7E
COUNTY Benton
APPLICATION NO. GR-3998

OWNER: Myrl P. Mulkey

MAILING ADDRESS: Route 3


LOCATION OF WELL: Owner's No. _____

CITY AND STATE: Corvallis, Oregon

SW $\frac{1}{4}$ NW $\frac{1}{4}$ Sec. 7 T. 13 N. S., R. 4 E W., W.M.

Bearing and distance from section or subdivision

corner 120' 45° angle from SE Cor. of SW $\frac{1}{4}$

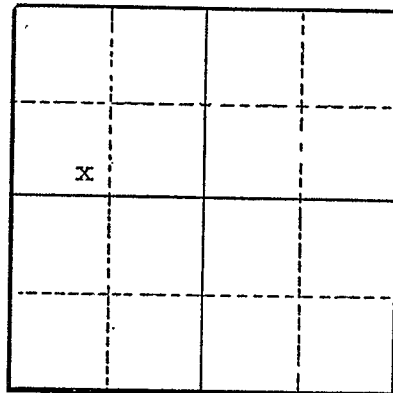

Section 7

Altitude at well _____

TYPE OF WELL: Drilled Date Constructed Feb., 1950

Depth drilled 32 ft. Depth cased 32 ft.

CASING RECORD:

6 inch casing set to 32 feet

FINISH:

Lower 5 feet perforated

AQUIFERS:

WATER LEVEL:

15 feet below surface

PUMPING EQUIPMENT: Type Raino-Flo Cornell

H.P. 10

Capacity 250 G.P.M.

WELL TESTS:

Drawdown 20 ft. after _____ hours 500 G.P.M.

Drawdown _____ ft. after _____ hours _____ G.P.M.

USE OF WATER Irrigation

Temp. _____ °F., 19.

SOURCE OF INFORMATION Well Registration Statement Cert. # GR-3605

DRILLER or DIGGER _____

ADDITIONAL DATA:

Log Water Level Measurements _____ Chemical Analysis _____ Aquifer Test _____

REMARKS:

Log:

Clay & gravel
Gravel

Thickness	Depth to Bottom
27	32
5	32