

BENT 6177

STATE ENGINEER
Salem, Oregon

Bent
6177 Well Record


STATE WELL NO. 13/4W-7M
COUNTY Benton
APPLICATION NO. GR-3999

OWNER: Myrl P. Mulkey MAILING ADDRESS: Route 3,

LOCATION OF WELL: Owner's No. CITY AND STATE: Corvallis, Oregon

NW 1/4 SW 1/4 Sec. 7 T. 13 N. 4 W., W.M.

Bearing and distance from section or subdivision corner 320' NE Cor. of NW 1/4 of SW 1/4

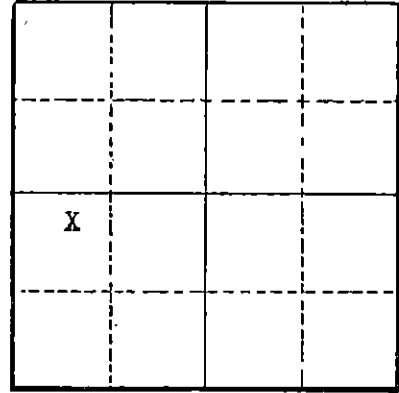

Altitude at well

TYPE OF WELL: Drilled Date Constructed Apr., 1951

Depth drilled 36 ft. Depth cased 36 ft.

Section 7

CASING RECORD:

6 inch casing set to 36 feet

FINISH:

Lower 5 feet perforated

AQUIFERS:

WATER LEVEL:

15 feet below surface

PUMPING EQUIPMENT: Type Raino-Flo Cornell Pump Co. H.P. 10
Capacity 250 G.P.M.

WELL TESTS:

Drawdown 20 ft. after 500 hours G.P.M.
Drawdown ft. after hours G.P.M.

USE OF WATER Irrigation Temp. °F., 19.

SOURCE OF INFORMATION Well Registration Statement Cert. # GR-3606

DRILLER or DIGGER Schaffer

ADDITIONAL DATA:

Log X Water Level Measurements Chemical Analysis Aquifer Test

REMARKS:	Thickness	Depth to Bottom
Log		
Chehalis soil	20	36
Sand & gravel	12	36
Gravel	4	36