

BENT 6191

STATE ENGINEER
Salem, Oregon


Well Record

STATE WELL NO. 13/5W-1P
COUNTY BENTON
APPLICATION NO. GR-2333
Bent 6191

OWNER: C. F. Hahn MAILING ADDRESS: Rt. 3

LOCATION OF WELL: Owner's No. CITY AND STATE: Corvallis, Oregon

SE 1/4 SW 1/4 Sec. 1 T. 13 S., R. 5 W., W.M.
Bearing and distance from section or subdivision corner
Approximately 1740' N. & 75° E.

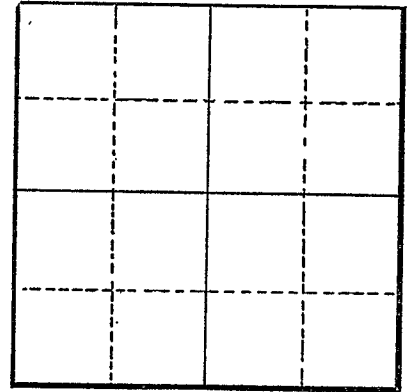

Section

Altitude at well

TYPE OF WELL: Driven Date Constructed 1939

Depth drilled 18 Depth cased

CASING RECORD:

FINISH:
4 perforated casings 2 ft. each

AQUIFERS:
Clay, hard pan and rock

WATER LEVEL:
12-feet

PUMPING EQUIPMENT: Type Fairbanks Morse H.P. 10
Capacity 275 G.P.M.

WELL TESTS:
Drawdown 2 ft. after hours Pumping 275 G.P.M.
Drawdown ft. after hours G.P.M.

USE OF WATER Irrigation Temp. °F., 19

SOURCE OF INFORMATION GR-2219

DRILLER or DIGGER

ADDITIONAL DATA:
Log Water Level Measurements Chemical Analysis Aquifer Test

REMARKS:

Top Section - Blue Clay 14
Hard Pan 1
Coarse Rock 3