

BENT 6249

STATE ENGINEER
Salem, Oregon

Well Record

Bent
6249

STATE WELL NO. 13/5W-7M
COUNTY Benton
APPLICATION NO. GR-3137

OWNER: Van W. Smith


MAILING ADDRESS: Route 3, Box 540

LOCATION OF WELL: Owner's No.

CITY AND STATE: Corvallis, Oregon

NW 1/4 SW 1/4 Sec. 7 T. 13 N. S., R. 5 E. W., W.M.

Bearing and distance from section or subdivision corner 2185' N. and 750' E.

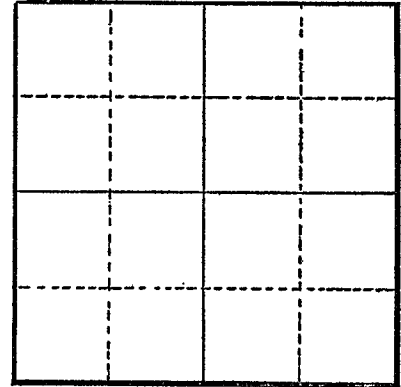

Section

Altitude at well

TYPE OF WELL: drilled Date Constructed 1950

Depth drilled 30' Depth cased 28'

CASING RECORD:

6"

FINISH:

5' pressed openings

AQUIFERS:

river silt, sand and gravel

WATER LEVEL:

10'

PUMPING EQUIPMENT: Type Rainflow H.P. 3
Capacity 60 G.P.M.

WELL TESTS:

Drawdown 5 ft. after hours pumping 70 G.P.M.
Drawdown ft. after hours G.P.M.

USE OF WATER Irrigation Temp. °F., 19

SOURCE OF INFORMATION GR-3178

DRILLER or DIGGER Frank L. Skillings

ADDITIONAL DATA:

Log X Water Level Measurements Chemical Analysis Aquifer Test

REMARKS:

River silt 2
Sand & gravel 29