

BENT 6250

STATE ENGINEER
Salem, Oregon

Well Record

Bent
6250


STATE WELL NO. 13/5W-7B(1)
COUNTY BENTON
APPLICATION NO. GR-3076

OWNER: Earl Gillaspie
MAILING ADDRESS: 1615 South 25th Street

LOCATION OF WELL: Owner's No. 1
CITY AND STATE: Salem, Oregon

SE 1/4 SE 1/4 Sec. 7 T. 13 N. S., R. 5 E. W., W.M.

Bearing and distance from section or subdivision
corner 34.1 chs. S. and 4.1 chs. E. of the NW
corner of DLC No. 41

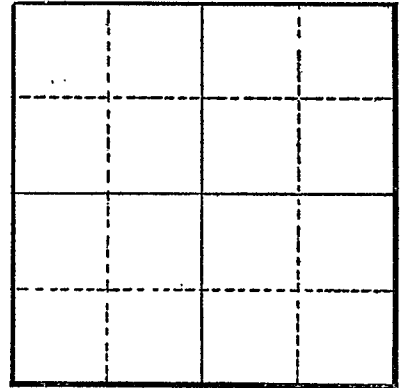

Section

Altitude at well

TYPE OF WELL: Drilled Date Constructed 1950

Depth drilled 45 feet Depth cased 45 feet

CASING RECORD:

8-inch

FINISH:

Perforations from 27 to 45

AQUIFERS:

Top soil and gravel

WATER LEVEL:

8 feet

PUMPING EQUIPMENT: Type Fairbanks-Morse Turbine H.P. 5
Capacity 100 G.P.M.

WELL TESTS:

Drawdown 30 ft. after hours Pumping 70 G.P.M.

Drawdown ft. after hours G.P.M.

USE OF WATER Irrigation Temp. °F., 19

SOURCE OF INFORMATION GR-2879

DRILLER or DIGGER C. A. Shafer

ADDITIONAL DATA:

Log Water Level Measurements Chemical Analysis Aquifer Test

REMARKS:

Top soil 0 18
Gravel 18 45