

BENT 6251
OBSERVATION WELL

STATE ENGINEER
Salem, Oregon

Well Record

STATE WELL NO. 13/5W-7R(2)
COUNTY BENTON
APPLICATION NO. GR-3077

OWNER: Earl Gillaspie (CLAUDE MARINER)


MAILING ADDRESS: 1615 South 25th Street

LOCATION OF WELL: Owner's No. 2

CITY AND STATE: Salem, Oregon

SE 1/4 SE 1/4 Sec. 7 T. 13 N. 5 E. S., R. 5 W., W.M.

Bearing and distance from section or subdivision corner 34.6 chs. S. and 9.7 chs. E. of the NW corner of DLC No. 41

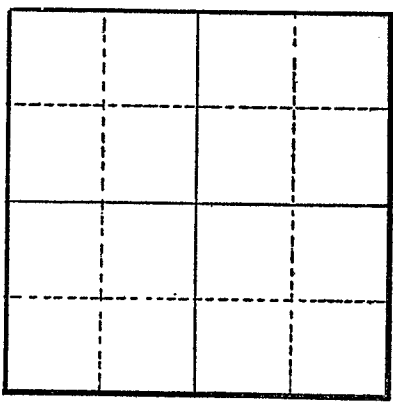

Section

Altitude at well

TYPE OF WELL: Drilled Date Constructed 1952

Depth drilled 60 feet Depth cased 60 feet

CASING RECORD:
8-inch

FINISH:

AQUIFERS:

WATER LEVEL:
6 feet

PUMPING EQUIPMENT: Type F. M. Turbine H.P. 5
Capacity G.P.M.

WELL TESTS:
Drawdown ft. after hours Pumping 200 G.P.M.
Drawdown ft. after hours G.P.M.

USE OF WATER Irrigation Temp. °F., 19

SOURCE OF INFORMATION GR-2880

DRILLER or DIGGER

ADDITIONAL DATA:
Log Water Level Measurements Chemical Analysis Aquifer Test

REMARKS: