

BENT 6255

STATE ENGINEER
Salem, Oregon

Well Record

*Bent
6255*

STATE WELL NO. 13/5W-8D(1)
COUNTY Benton
APPLICATION NO. GR-286

OWNER: Bruce Brahs

MAILING ADDRESS:

LOCATION OF WELL: Owner's No. #1

CITY AND STATE:


Corvallis, Oregon

NW 1/4 NW 1/4 Sec. 8 T. 13 N. S. R. 5 E. W., W.M.

Bearing and distance from section or subdivision

corner 5.46 chains N and 23.474 chains

N. 89° 36' W. of NW corner of DLC #41

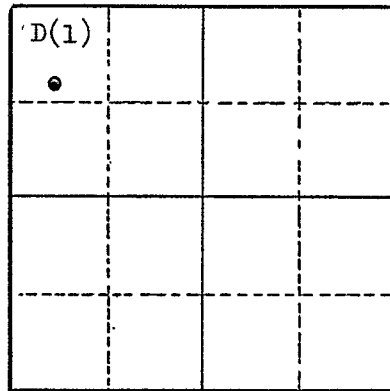

Section 8

Altitude at well 250' Interpolated

TYPE OF WELL: Drilled Date Constructed 1920??

Depth drilled 28 Depth cased unknown

CASING RECORD:

8-inch casing depth unknown

FINISH:

unknown

AQUIFERS:

unknown

WATER LEVEL:

14 feet below land surface

PUMPING EQUIPMENT: Type Installing new pump H.P.

Capacity G.P.M.

WELL TESTS:

Drawdown unknown ft. after hours G.P.M.

Drawdown ft. after hours G.P.M.

USE OF WATER Irrigation 1.2 acres Temp. °F., 19

SOURCE OF INFORMATION Registration statement GR-286

DRILLER or DIGGER unknown

ADDITIONAL DATA:

Log No. Water Level Measurements Chemical Analysis Aquifer Test

REMARKS: