

BENT 6272

STATE ENGINEER
Salem, Oregon

Well Record

*Bent
6272*

STATE WELL NO. 13/5W-12G
COUNTY Benton
APPLICATION NO. GR-3574

OWNER: Alex Smith


MAILING ADDRESS: Route 3

LOCATION OF WELL: Owner's No. _____

CITY AND STATE: Corvallis, Oregon

SW 1/4 NE 1/4 Sec. 12 T. 13 S., R. 5 W., W.M.

Bearing and distance from section or subdivision
corner 196 chs. S. and 7.6 chs. E. of W. NW corner
Dudley Derr D.L.C. #61

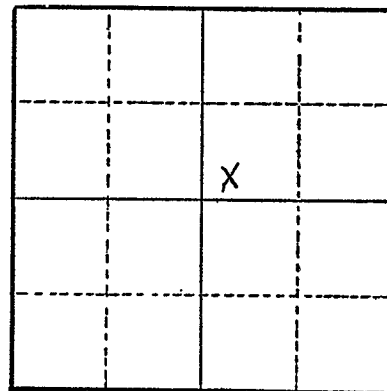

Section 12

Altitude at well _____

TYPE OF WELL: Drilled Date Constructed 1953

Depth drilled 44 ft. Depth cased _____

CASING RECORD:

FINISH:

AQUIFERS:

WATER LEVEL:

10 feet below surface

PUMPING EQUIPMENT: Type Rainflow 2 1/2 W-10-2 Centrifugal H.P. 10
Capacity 250 G.P.M.

WELL TESTS:

Drawdown 12 ft. after _____ hours 250 G.P.M.

Drawdown 15 ft. after _____ hours 500 G.P.M.

USE OF WATER Irrigation Temp. _____ °F., 19____

SOURCE OF INFORMATION Well Registration Statement

DRILLER or DIGGER Claude Shafer

ADDITIONAL DATA:

Log _____ Water Level Measurements _____ Chemical Analysis _____ Aquifer Test _____

REMARKS: