

BENT 6281

STATE ENGINEER
Salem, Oregon

Well Record

Bent
6281

STATE WELL NO. 13/5W-13B
COUNTY Benton
APPLICATION NO. GR-1309

GR- 1266

OWNER: Dale & Jean Schrock

MAILING ADDRESS: Rt. 3, Box 544


LOCATION OF WELL: Owner's No.

CITY AND STATE: Corvallis, Oregon

NW 1/4 NE 1/4 Sec. 13 T. 13 S., R. 5 W., W.M.

Bearing and distance from section or subdivision

corner 12' E. from NW cor. Sec. 13.

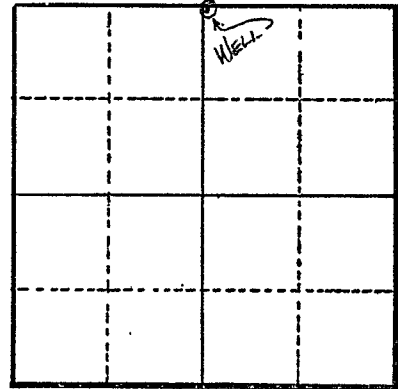

Section 13

Altitude at well 245 ft.

TYPE OF WELL: Drilled Date Constructed 1951

Depth drilled 29 ft. Depth cased 29 ft.

CASING RECORD:

12 inch

FINISH:

Perforated from 24 to 29 ft.

AQUIFERS:

WATER LEVEL:

13 ft.

PUMPING EQUIPMENT: Type F. M. 4 x 5 in. Cent. H.P. 30

Capacity 600 G.P.M.

WELL TESTS:

Drawdown 2 ft. after hours 600 G.P.M.

Drawdown ft. after hours G.P.M.

USE OF WATER Irrigation Temp. °F., 19

SOURCE OF INFORMATION G. R. Record

DRILLER or DIGGER

ADDITIONAL DATA:

Log N.A. Water Level Measurements Chemical Analysis Aquifer Test

REMARKS:

Irrigation of 96 acres.