

BENT 6283

STATE ENGINEER
Salem, Oregon

Well Record

Bent
6283

STATE WELL NO. 13/5W-13.G
COUNTY Benton
APPLICATION NO. GR-2249

OWNER: Neil E. Vanderburg


MAILING ADDRESS: Rt. 3, Box 545

LOCATION OF WELL: Owner's No.

CITY AND STATE: Corvallis, Oregon

SW 1/4 NE 1/4 Sec. 13 T. 13 N. S., R. 5 E. W., W.M.

Bearing and distance from section or subdivision corner 173' N & 191' E from the NW corner
Abel Hurlbutt DLC #60

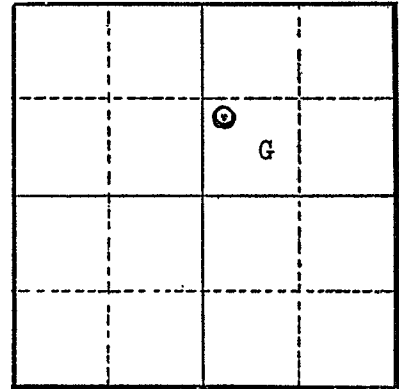

Section 13

Altitude at well

TYPE OF WELL: Drilled Date Constructed 1952

Depth drilled 32' Depth cased

CASING RECORD:

4-inch

FINISH:

AQUIFERS:

WATER LEVEL:

14'

PUMPING EQUIPMENT: Type Fairbanks Morse combination H.P. 7 1/2
Capacity 225 G.P.M.

WELL TESTS:

Drawdown 2 ft. after 300 hours G.P.M.
Drawdown ft. after hours G.P.M.

USE OF WATER Irrigation Temp. °F., 19

SOURCE OF INFORMATION GR-3863
DRILLER or DIGGER Bill Howell

ADDITIONAL DATA:

Log NA Water Level Measurements Chemical Analysis Aquifer Test

REMARKS: