

BENT 6289

STATE ENGINEER
Salem, Oregon

Well Record

*Bent
6289*


STATE WELL NO. 13/5W-15A(1)
COUNTY Benton
APPLICATION NO. GR-340

OWNER: Mrs. J. Reese Mallow
MAILING ADDRESS: 1153 Fillmore

LOCATION OF WELL: Owner's No. #1
CITY AND STATE: Corvallis, Oregon

NE 1/4 NE 1/4 Sec. 15 T. 13 N. S. R. 5 W., W.M.

Bearing and distance from section or subdivision
corner S 67° West from the NE corner of Section 15

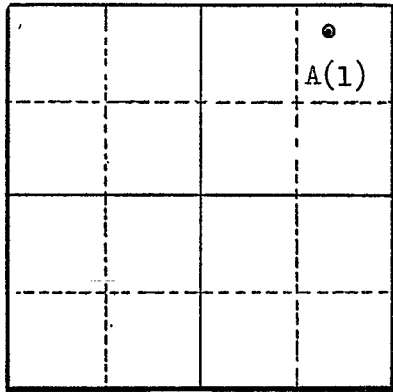

Section 15

Altitude at well 220' Interpolated

TYPE OF WELL: Drilled Date Constructed 3/30/50

Depth drilled 65 Depth cased 41

CASING RECORD:

6-inch casing 20#/foot set from 0 to 41 feet

FINISH:

unknown

AQUIFERS:

sand and gravel from 21 to 65 feet

WATER LEVEL:

-

PUMPING EQUIPMENT: Type Peerless deep well turbine 3" H.P. 5
Capacity 150 G.P.M.

WELL TESTS:

Drawdown 10 ft. after hours pumping 100 G.P.M.
Drawdown ft. after hours G.P.M.

USE OF WATER Irrigation 16 acres Temp. °F., 19
SOURCE OF INFORMATION Registration Statement GR-340

DRILLER or DIGGER

ADDITIONAL DATA:

Log yes Water Level Measurements Chemical Analysis Aquifer Test

REMARKS:

