

STATE ENGINEER  
Salem, Oregon

BENT 6300  
Well Record

*Bent 6300*  
STATE WELL NO. 13/5W-21B  
COUNTY Benton  
APPLICATION NO. GR-3697

OWNER: W. Guy Parker, Secretary  
Muddy River Hunt Club, Inc.


MAILING ADDRESS: 215 Monroe St.

LOCATION OF WELL: Owner's No. \_\_\_\_\_

CITY AND STATE: Corvallis, Oregon

SW 1/4 NW 1/4 Sec. 21 T. 13 S., R. 5 W., W.M.

Bearing and distance from section or subdivision  
corner 1025 feet E. & 210 feet N. from W 1/4 cor.

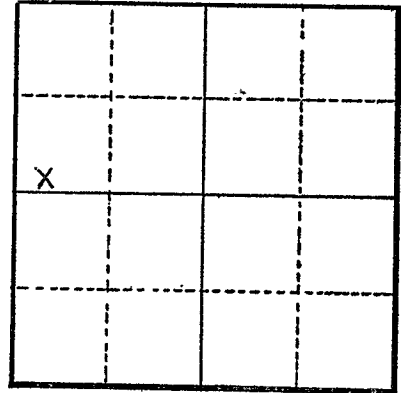

Section 21

Altitude at well \_\_\_\_\_

TYPE OF WELL: Driven Date Constructed \_\_\_\_\_

Depth drilled \_\_\_\_\_ Depth cased \_\_\_\_\_

CASING RECORD:

FINISH:

AQUIFERS:

WATER LEVEL:

PUMPING EQUIPMENT: Type Berkley H.P. 1/4  
Capacity 15 G.P.M.

WELL TESTS:

Drawdown \_\_\_\_\_ ft. after \_\_\_\_\_ hours \_\_\_\_\_ G.P.M.  
Drawdown \_\_\_\_\_ ft. after \_\_\_\_\_ hours \_\_\_\_\_ G.P.M.

USE OF WATER Irrigation Temp. \_\_\_\_\_ °F., 19 \_\_\_\_\_

SOURCE OF INFORMATION Well Registration Statement

DRILLER or DIGGER \_\_\_\_\_

ADDITIONAL DATA:

Log \_\_\_\_\_ Water Level Measurements \_\_\_\_\_ Chemical Analysis \_\_\_\_\_ Aquifer Test \_\_\_\_\_

REMARKS: