

STATE ENGINEER  
Salem, Oregon

**BENT 6302**  
**Well Record**

*Bent*  
*6302*

STATE WELL NO. 13/51-214  
COUNTY Benton  
APPLICATION NO. 22-3431

OWNER: Paul Rigor


MAILING ADDRESS: Route 3, Box 585

LOCATION OF WELL: Owner's No. \_\_\_\_\_

CITY AND STATE: Corvallis, Oregon

SE  $\frac{1}{4}$  NE  $\frac{1}{4}$  Sec. 21 T. 13 ~~N.~~ S., R. 5 ~~E.~~ W., W.M.

Bearing and distance from section or subdivision corner 21-22, to 1535' S. and then 312' "

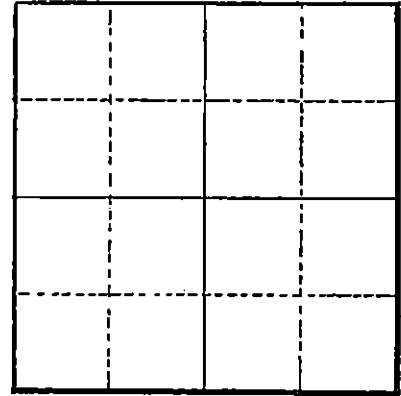

Section \_\_\_\_\_

Altitude at well \_\_\_\_\_

TYPE OF WELL: drilled Date Constructed 1953

Depth drilled 35' Depth cased \_\_\_\_\_

CASING RECORD:

6'

FINISH:

AQUIFERS:

WATER LEVEL:

6'

PUMPING EQUIPMENT: Type Fairbanks Morse H.P. 5

Capacity 100 G.P.M.

WELL TESTS:

Drawdown \_\_\_\_\_ ft. after \_\_\_\_\_ hours \_\_\_\_\_ G.P.M.

Drawdown \_\_\_\_\_ ft. after \_\_\_\_\_ hours \_\_\_\_\_ G.P.M.

USE OF WATER Irrigation Temp. \_\_\_\_\_ °F. \_\_\_\_\_, 19\_\_\_\_

SOURCE OF INFORMATION 22-3174

DRILLER or DIGGER \_\_\_\_\_

ADDITIONAL DATA:

Log \_\_\_\_\_ Water Level Measurements \_\_\_\_\_ Chemical Analysis \_\_\_\_\_ Aquifer Test \_\_\_\_\_

REMARKS: