

BENT 6304
OBSERVATION WELL

STATE ENGINEER
Salem, Oregon

Well Record


STATE WELL NO. 13/5W-22B(1)
COUNTY BENTON
APPLICATION NO. GR-2983

OWNER: Clayton Mann (MALCOLM THOMPSON) MAILING ADDRESS: Rt. 2, Box 181

LOCATION OF WELL: Owner's No. _____ CITY AND STATE: Corvallis, Oregon

NW 1/4 NE 1/4 Sec. 22 T. 13 S., R. 5 W., W.M.

Bearing and distance from section or subdivision corner 2230' S. 65° W.

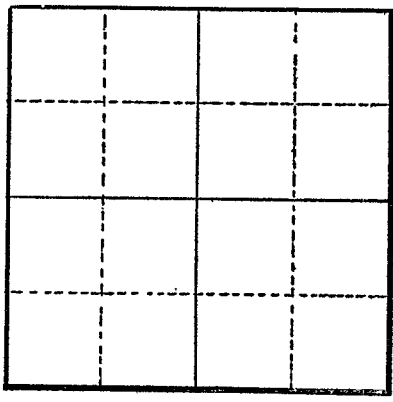

Section _____

Altitude at well _____

TYPE OF WELL: Drilled Date Constructed 1952

Depth drilled 180 Depth cased 120

CASING RECORD:

8-inch

FINISH:

AQUIFERS:

WATER LEVEL:
20-feet

PUMPING EQUIPMENT: Type G E Repulsion Induction H.P. 5
Capacity 60 G.P.M.

WELL TESTS:
Drawdown 10 ft. after _____ hours Pumping 60 G.P.M.
Drawdown _____ ft. after _____ hours _____ G.P.M.

USE OF WATER Irrigation Temp. _____ °F., 19

SOURCE OF INFORMATION GR-2794

DRILLER or DIGGER Morton Sargent, Albany, Oregon
ADDITIONAL DATA:
Log _____ Water Level Measurements _____ Chemical Analysis _____ Aquifer Test _____

REMARKS: