

BENT 6318

STATE ENGINEER  
Salem, Oregon

Well Record


Bent  
6318

STATE WELL NO. 13/5W-24F(1)  
COUNTY Benton  
APPLICATION NO. GR-650

OWNER: John G. Graham MAILING ADDRESS: Route 3, Box 555

LOCATION OF WELL: Owner's No. #1 CITY AND STATE: Corvallis, Oregon

SE 1/4 NW 1/4 Sec. 24 T. 13 S., R. 5 W., W.M.  
Bearing and distance from section or subdivision  
corner 381' N. 65° W. from angle iron located  
on 1/4 section line 880' W. of center of  
section 24.

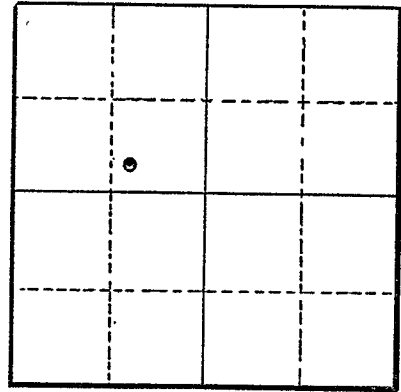

Section 24

Altitude at well 242' Interpolated

TYPE OF WELL: Drilled Date Constructed 1940

Depth drilled 25' Depth cased 25'

CASING RECORD:

6-inch

FINISH:

AQUIFERS:

WATER LEVEL:

10 feet

PUMPING EQUIPMENT: Type F. M. Centrifugal H.P. Tractor  
Capacity 650 G.P.M.

WELL TESTS:

Drawdown 7 ft. after hours 650 G.P.M.

Drawdown ft. after hours G.P.M.

USE OF WATER Irrigation 83 acres Temp. °F., 19

SOURCE OF INFORMATION GR-650

DRILLER or DIGGER Claud Schaffer, Philomath, Oregon

ADDITIONAL DATA:

Log Water Level Measurements Chemical Analysis Aquifer Test

REMARKS: