

BENT 6320

STATE ENGINEER
Salem, Oregon

Well Record

Bent 6320 STATE WELL NO. 13/5W-24L(1)
COUNTY Benton
APPLICATION NO. GR-651

OWNER: John G. Graham


MAILING ADDRESS: Route 3, Box 555

LOCATION OF WELL: Owner's No. #2

CITY AND STATE: Corvallis, Oregon

NE 1/4 SW 1/4 Sec. 24 T. 13 S., R. 5 W., W.M.

Bearing and distance from section or subdivision corner 902' S. 5° 50' W. from angle iron located on 1/4 section line 880' west of center of Section 24

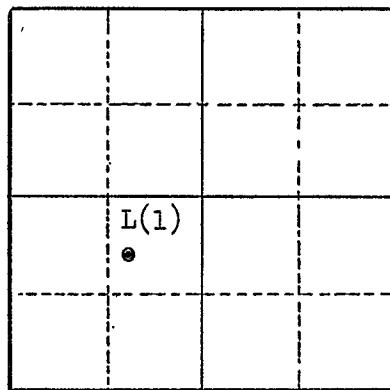

Section 24

Altitude at well 245' Interpolated

TYPE OF WELL: Drilled Date Constructed 1941

Depth drilled 25' Depth cased 25'

CASING RECORD:

6-inch

FINISH:

AQUIFERS:

WATER LEVEL:

10 feet

PUMPING EQUIPMENT: Type Gould centrifugal H.P. 7 1/2
Capacity 220 G.P.M.

WELL TESTS:

Drawdown 2 ft. after 220 hours G.P.M.
Drawdown ft. after hours G.P.M.

USE OF WATER Irrigation 25 acres Temp. °F., 19

SOURCE OF INFORMATION GR-651

DRILLER or DIGGER

ADDITIONAL DATA:

Log Water Level Measurements Chemical Analysis Aquifer Test

REMARKS: