

BENT 6328

STATE ENGINEER
Salem, Oregon

Well Record

Bent
6328 STATE WELL NO. 13/5W-27P
COUNTY Benton
APPLICATION NO. GR-1708

GR- 1657

OWNER: Wayne Riley

MAILING ADDRESS: Rt. 3, Box 572


LOCATION OF WELL: Owner's No.

CITY AND STATE: Corvallis, Oregon

SE 1/4 SW 1/4 Sec. 27 T. 13 S., R. 5 W., W.M.

Bearing and distance from section or subdivision

corner 525' N. & 220' W. from S 1/4 cor. Sec. 27

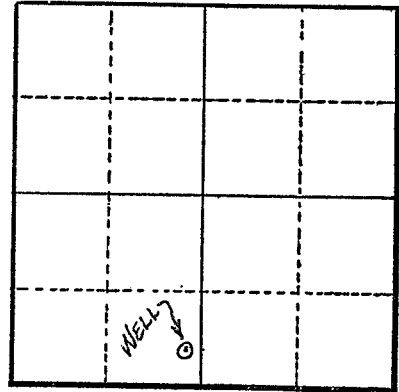

Section 27

Altitude at well 260'

TYPE OF WELL: Drilled Date Constructed 1948

Depth drilled 90' Depth cased 90'

CASING RECORD:

8"

FINISH:

Slot perforations from 80 to 90 ft.

AQUIFERS:

WATER LEVEL:

17'

PUMPING EQUIPMENT: Type Pomona turbine 6"

H.P. 40

Capacity 500 G.P.M.

WELL TESTS:

Drawdown 18 ft. after 500 hours G.P.M.

Drawdown ft. after hours G.P.M.

USE OF WATER Irrigation Temp. °F. 19

SOURCE OF INFORMATION GR Record

DRILLER or DIGGER Floyd Schaeffer

ADDITIONAL DATA:

Log N.A. Water Level Measurements Chemical Analysis Aquifer Test

REMARKS:

Irrigation of 100 acres.