

BENT 6344

STATE ENGINEER  
Salem, Oregon

Well Record

Bent  
6344

STATE WELL NO. 13/5W-35B  
COUNTY Benton  
APPLICATION NO. GR-1669

GR- 1620

OWNER: C. & E. Miller Farms

MAILING ADDRESS: Rt. 3, Box 554


LOCATION OF WELL: Owner's No.

CITY AND STATE: Corvallis, Oregon

NW 1/4 NE 1/4 Sec. 35 T. 13 S., R. 5 W., W.M.

Bearing and distance from section or subdivision

corner 1597' N.86°30'E. to NE cor. Sec. 35

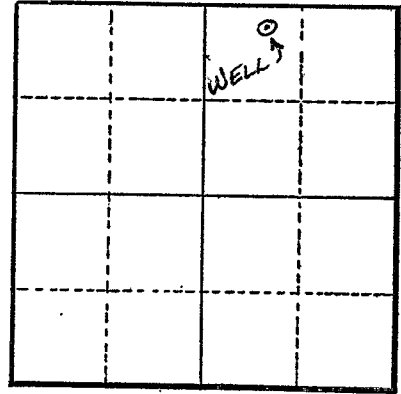

Section 35

Altitude at well 245'

TYPE OF WELL: Drilled Date Constructed 1946

Depth drilled 30' Depth cased 30'

CASING RECORD:

6"

FINISH:

Perforated from 25 to 30 ft.

AQUIFERS:

WATER LEVEL:

15'

PUMPING EQUIPMENT: Type 3" x 4" Cent.

H.P. 40

Capacity 300 G.P.M.

WELL TESTS:

Drawdown 5 ft. after 150 hours G.P.M.

Drawdown ft. after hours G.P.M.

USE OF WATER Irrigation Temp. °F., 19

SOURCE OF INFORMATION GR Record

DRILLER or DIGGER

ADDITIONAL DATA:

Log N.A. Water Level Measurements Chemical Analysis Aquifer Test

REMARKS:

Irrigation of 40 acres.