

BENT 6353

STATE ENGINEER
Salem, Oregon

Well Record

Bent
6353

STATE WELL NO. 13/5W-36J
COUNTY BENTON
APPLICATION NO. GR-2441

OWNER: George F. Horning


MAILING ADDRESS: Rt. 3, Box 588

LOCATION OF WELL: Owner's No.

CITY AND STATE: Corvallis, Oregon

NE 1/4 SE 1/4 Sec. 36 T. 13 S., R. 5 W., W.M.

Bearing and distance from section or subdivision corner 165' W. hence S. 72° 45' E. 2071'

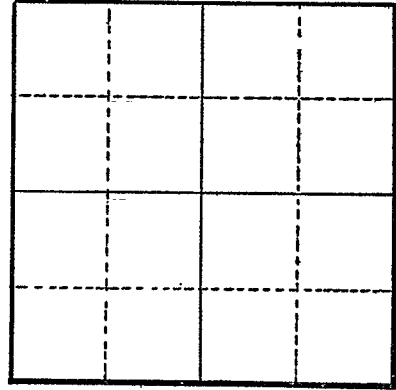

Section

Altitude at well

TYPE OF WELL: Driven Date Constructed 1948

Depth drilled 25 Depth cased 20

CASING RECORD:

5-inch

FINISH:

Slotted from 20' to 25'

AQUIFERS:

WATER LEVEL:

12-feet

PUMPING EQUIPMENT: Type Centrifugal H.P. 40
Capacity 800 G.P.M.

WELL TESTS:

Drawdown ft. after hours Pumping 800 G.P.M.

Drawdown ft. after hours G.P.M.

USE OF WATER Irrigation Temp. °F. 19

SOURCE OF INFORMATION GR-2314

DRILLER or DIGGER

ADDITIONAL DATA:

Log Water Level Measurements Chemical Analysis Aquifer Test

REMARKS: