

BENT 6354

STATE ENGINEER
Salem, Oregon

Well Record

Bent
6354
STATE WELL NO. 13/5W - 36J
COUNTY BENTON
APPLICATION NO. GR-2138

OWNER: R. G. Rickard


MAILING ADDRESS: Rt. 3, Box 586

LOCATION OF WELL: Owner's No. #2

CITY AND STATE: Corvallis, Oregon

NE 1/4 SE 1/4 Sec. 36 T. 13 N. S., R. 5 W., W.M.

Bearing and distance from section or subdivision corner 517' S. 79° E.

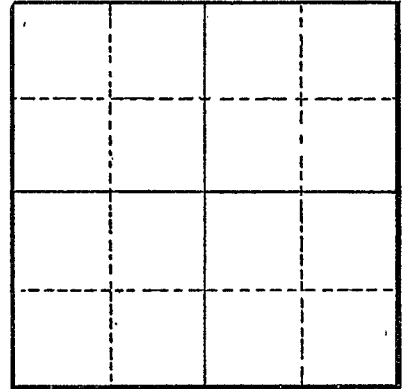

Section

Altitude at well

TYPE OF WELL: Driven Date Constructed 1951

Depth drilled 30 Depth cased 30

CASING RECORD:

4-inch

FINISH:

Perforations from 22 to 30

AQUIFERS:

WATER LEVEL:

12-feet

PUMPING EQUIPMENT: Type Centrifugal H.P. 30

Capacity 300 G.P.M.

WELL TESTS:

Drawdown ft. after hours Pumping 500 G.P.M.

Drawdown ft. after hours G.P.M.

USE OF WATER Irrigation Temp. °F., 19

SOURCE OF INFORMATION GR-2051

DRILLER or DIGGER Frank Holloway, (deceased)

ADDITIONAL DATA:

Log Water Level Measurements Chemical Analysis Aquifer Test

REMARKS: