

STATE ENGINEER
Salem, Oregon

Well Record

Bent
6355

STATE WELL NO. 13/5W-36K
COUNTY BENTON
APPLICATION NO. GR-2440

OWNER: George F. Horning


MAILING ADDRESS: Rt. 3, Box 588,

LOCATION OF WELL: Owner's No.

CITY AND STATE: Corvallis, Oregon

NW 1/4 SE 1/4 Sec. 36 T. 13 S., R. 5 W., W.M.

Bearing and distance from section or subdivision corner 165' W. hence 1147' S. 41° 51' E.

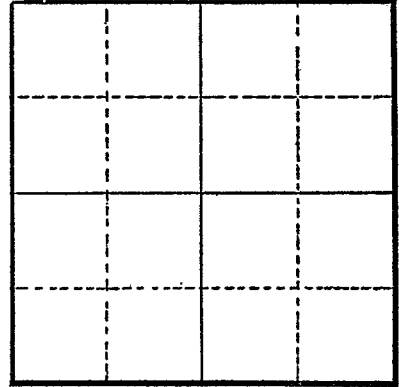

Section

Altitude at well

TYPE OF WELL: Driven Date Constructed 1948

Depth drilled 25 Depth cased 20

CASING RECORD:

- 3-inch
- 4-inch

FINISH:

Slotted from 20 to 25

AQUIFERS:

WATER LEVEL:

12-feet

PUMPING EQUIPMENT: Type Berkley Centrifugal H.P. 15
Capacity 350 G.P.M.

WELL TESTS:

Drawdown ft. after hours Pumping 500 G.P.M.
Drawdown ft. after hours G.P.M.

USE OF WATER Irrigation Temp. °F. 19

SOURCE OF INFORMATION GR-2313

DRILLER or DIGGER

ADDITIONAL DATA:

Log Water Level Measurements Chemical Analysis Aquifer Test

REMARKS: