

BENT 6358

STATE ENGINEER
Salem, Oregon

Well Record

STATE WELL NO. 13/5W-36M
COUNTY Benton
APPLICATION NO. GR-3398

OWNER: Chris C. Lindseth

MAILING ADDRESS: Route 3, Box 620


LOCATION OF WELL: Owner's No. _____

CITY AND STATE: Monroe, Oregon

SW 1/4 NW 1/4 Sec. 36 T. 13 N. S., R. 5 E. W., W.M.

Bearing and distance from section or subdivision

corner N. 56° E. 621.87'

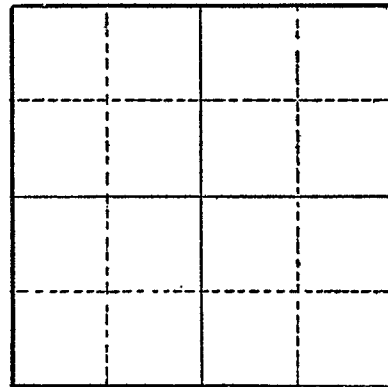

Section _____

Altitude at well _____

TYPE OF WELL: drilled Date Constructed 1947

Depth drilled 21' Depth cased _____

CASING RECORD:

4"

FINISH:

AQUIFERS:

WATER LEVEL:

13'

PUMPING EQUIPMENT: Type 3" H.P. 20
Capacity 300 G.P.M.

WELL TESTS:

Drawdown _____ ft. after _____ hours _____ G.P.M.
Drawdown _____ ft. after _____ hours _____ G.P.M.

USE OF WATER Agriculture Temp. _____ °F. _____, 19_____

SOURCE OF INFORMATION GR-3145

DRILLER or DIGGER _____

ADDITIONAL DATA:

Log _____ Water Level Measurements _____ Chemical Analysis _____ Aquifer Test _____

REMARKS: