

BENT 6360

STATE ENGINEER
Salem, Oregon

Well Record

6360

STATE WELL NO. 13/5W-36P
COUNTY Benton
APPLICATION NO. GR-3399

OWNER: Chris C. Lindseth

MAILING ADDRESS: Route 3, Box 620


LOCATION OF WELL: Owner's No.

CITY AND STATE: Monroe, Oregon

SE 1/4 SW 1/4 Sec. 36 T. 13 N. S., R. 5 E. W., W.M.

Bearing and distance from section or subdivision

corner 595.75' N. 44° W.

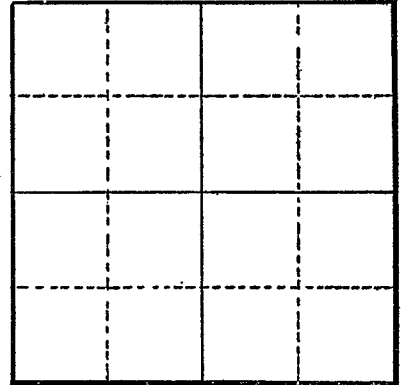

Section

Altitude at well

TYPE OF WELL: drilled Date Constructed 1946

Depth drilled 21' Depth cased

CASING RECORD:

4"

FINISH:

AQUIFERS:

WATER LEVEL:

12'

PUMPING EQUIPMENT: Type 3" H.P. 20
Capacity 300 G.P.M.

WELL TESTS:

Drawdown ft. after hours G.P.M.
Drawdown ft. after hours G.P.M.

USE OF WATER Agriculture Temp. °F., 19

SOURCE OF INFORMATION GR-3146

DRILLER or DIGGER

ADDITIONAL DATA:

Log Water Level Measurements Chemical Analysis Aquifer Test

REMARKS: