

STATE ENGINEER
Salem, Oregon

Well Record

Bent STATE WELL NO. 13/6W-2C
6422 COUNTY Benton
APPLICATION NO. GR-1774

OWNER: Herbert Pearson


MAILING ADDRESS: Route 2

LOCATION OF WELL: Owner's No.

CITY AND STATE: Corvallis, Oregon

NE 1/4 NW 1/4 Sec. 2 T. 13 N. S., R. 6 E. W., W.M.

Bearing and distance from section or subdivision
corner 1584' East and 420' South from NW corner
Section 2

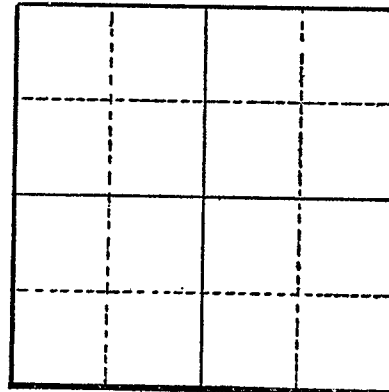

Section 2

Altitude at well

TYPE OF WELL: Drilled Date Constructed 1955

Depth drilled 60 Depth cased 14

CASING RECORD:

6" 0 to 14 feet

FINISH:

AQUIFERS:

WATER LEVEL:

6 feet

PUMPING EQUIPMENT: Type Fairbanks Morse Jet H.P. 1
Capacity 16 2/3 G.P.M.

WELL TESTS:

Drawdown ft. after hours G.P.M.
Drawdown ft. after hours G.P.M.

USE OF WATER Domestic & Irrigation Temp. °F. 19
SOURCE OF INFORMATION GR-1774

DRILLER or DIGGER

ADDITIONAL DATA:

Log Water Level Measurements Chemical Analysis Aquifer Test

REMARKS:

