

OWNER: G. M. Gragg


MAILING ADDRESS: RR 1

LOCATION OF WELL: Owner's No.

CITY AND STATE: Monroe, Oregon

SW 1/4 SW 1/4 Sec. 7 T. 14 N. S, R. 4 E. W., W.M.

Bearing and distance from section or subdivision corner 1360' N. 53° E.

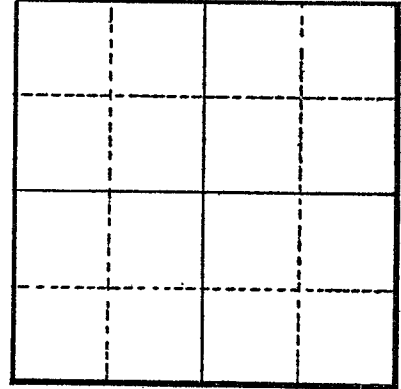

Section

Altitude at well

TYPE OF WELL: driven Date Constructed 1952

Depth drilled 22' Depth cased 22'

CASING RECORD:

5"

FINISH:

1/4" x 5" perforations from point to 4'

AQUIFERS:

WATER LEVEL:

10'

PUMPING EQUIPMENT: Type 2 1/2" Cent. H.P. 25  
Capacity app. 300 G.P.M.

WELL TESTS:

Drawdown ft. after hours G.P.M.  
Drawdown ft. after hours G.P.M.

USE OF WATER Irrigation Temp. °F., 19

SOURCE OF INFORMATION GR-3197

DRILLER or DIGGER Frank Hollaway (deceased)

ADDITIONAL DATA:

Log Water Level Measurements Chemical Analysis Aquifer Test

REMARKS: