

STATE ENGINEER
Salem, Oregon

Well Record

STATE WELL NO. 14/4W-30E
COUNTY Benton
APPLICATION NO. GR-4101

OWNER: John L. Shook


MAILING ADDRESS: Route 3

LOCATION OF WELL: Owner's No. _____

CITY AND STATE: Junction City, Oregon

SW 1/4 NW 1/4 Sec. 30 T. 14 S., R. 4 W., W.M.

Bearing and distance from section or subdivision
corner 600' N. 51° W. to NW Cor. Lot 26, Sec. 30

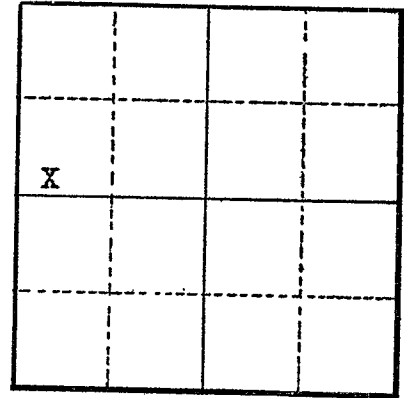

Section 30

Altitude at well _____

TYPE OF WELL: Driven Date Constructed 1945

Depth drilled 21 ft. Depth cased 21 ft.

CASING RECORD:

4 inch steel casing set to 21 feet

FINISH:

slotted perforations, size and number unknown from 16 to 21 feet

AQUIFERS:

WATER LEVEL:

12 feet below surface

PUMPING EQUIPMENT: Type Fairbanks Morse centrifugal 2 1/2 x 2 H.P. 24
Capacity 250 G.P.M.

WELL TESTS:

Drawdown _____ ft. after _____ hours _____ G.P.M.

Drawdown _____ ft. after _____ hours _____ G.P.M.

USE OF WATER Irrigation Temp. _____ °F. _____, 19____

SOURCE OF INFORMATION Well Registration Statement Cert. # GR-3690

DRILLER or DIGGER _____

ADDITIONAL DATA:

Log _____ Water Level Measurements _____ Chemical Analysis _____ Aquifer Test _____

REMARKS: