

Well Record

STATE WELL NO. 14/LAW-30F
COUNTY BENTON
APPLICATION NO. GR-2930

OWNER: LeRoy Tillery


MAILING ADDRESS: Rt. 3,

LOCATION OF WELL: Owner's No.

CITY AND STATE: Junction City, Oregon

SE 1/4 NW 1/4 Sec. 30 T. 14 S., R. 4W W., W.M.

Bearing and distance from section or subdivision corner W. 434' hence S. 300'

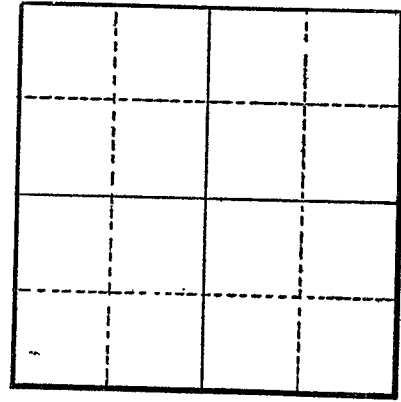

Section

Altitude at well

TYPE OF WELL: driven Date Constructed 1946

Depth drilled 21 Depth cased 21

CASING RECORD:

4-inch

FINISH:

Slotted, size and number unknown from 16 to 21

AQUIFERS:

WATER LEVEL:

12-feet

PUMPING EQUIPMENT: Type Fairbanks Morse Centrifugal

Capacity 200 G.P.M. H.P.

WELL TESTS:

Drawdown ft. after hours Pumping 200 G.P.M.

Drawdown ft. after hours G.P.M.

USE OF WATER Irrigation

SOURCE OF INFORMATION GR-2756 Temp. °F. 19

DRILLER or DIGGER

ADDITIONAL DATA:

Log Water Level Measurements Chemical Analysis Aquifer Test

REMARKS: