

STATE ENGINEER
Salem, Oregon

Well Record

Ben STATE WELL NO. 14/LW-30L
6616 COUNTY Benton
APPLICATION NO. GR-3003

OWNER: Lester E. and Marie A. Talbott

MAILING ADDRESS: Route 3


LOCATION OF WELL: Owner's No. 1

CITY AND STATE: Junction City, Oregon

NE $\frac{1}{4}$ SW $\frac{1}{4}$ Sec. 30 T. 14 S., R. 4 W., W.M.

Bearing and distance from section or subdivision

corner N. 1940' E. 1410' of the SW Corner

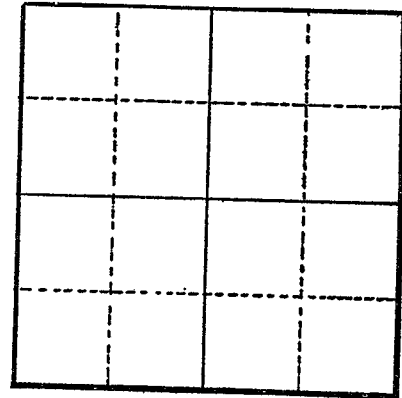

Section

Altitude at well

TYPE OF WELL: driven Date Constructed 1941

Depth drilled 24 Depth cased

CASING RECORD:

FINISH:

Standard perforation from 18 to 22

AQUIFERS:

WATER LEVEL:

12 feet

PUMPING EQUIPMENT: Type Berkeley Centrifugal

Capacity 525 G.P.M. H.P. 15

WELL TESTS:

Drawdown ft. after hours G.P.M.

Drawdown ft. after hours G.P.M.

USE OF WATER Irrigation

SOURCE OF INFORMATION GR-2812 Temp. °F., 19....

DRILLER or DIGGER

ADDITIONAL DATA:

Log Water Level Measurements Chemical Analysis Aquifer Test

REMARKS: