

STATE ENGINEER  
Salem, Oregon

# Well Record

STATE WELL NO. 14/4W-30M  
COUNTY Benton  
APPLICATION NO. GR-4227

OWNER: Chester E. Elder

MAILING ADDRESS: Rt. 3 Box 714


LOCATION OF WELL: Owner's No. \_\_\_\_\_

CITY AND STATE: Junction City, Oregon

NW  $\frac{1}{4}$  SW  $\frac{1}{4}$  Sec. 30 T. 14 S., R. 4 W., W.M.

Bearing and distance from section or subdivision

corner 16.5 chains S & 6.5 chains E of the  $\frac{1}{4}$ -section corner on the W line of Sec. 30

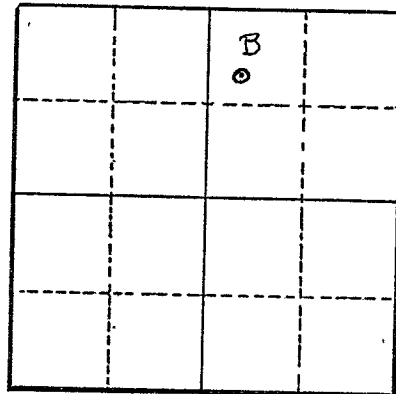

Section 30

Altitude at well \_\_\_\_\_

TYPE OF WELL: Drilled Date Constructed 1955

Depth drilled 25' Depth cased 25'

### CASING RECORD:

5-inch

### FINISH:

I 24' to 25'

### AQUIFERS:

### WATER LEVEL:

14'

PUMPING EQUIPMENT: Type Berkley

Capacity 50

G.P.M.

H.P.

10

### WELL TESTS:

Drawdown 4 ft. after \_\_\_\_\_ hours 80

G.P.M.

Drawdown 4 ft. after \_\_\_\_\_ hours 80

G.P.M.

USE OF WATER Irrigation

Temp. \_\_\_\_\_ °F.

19

SOURCE OF INFORMATION GR-3842

DRILLER or DIGGER O. B. Nye

### ADDITIONAL DATA:

Log NA

Water Level Measurements \_\_\_\_\_

Chemical Analysis \_\_\_\_\_

Aquifer Test \_\_\_\_\_

### REMARKS: