

# Well Record

STATE WELL NO. 14/4W-30N  
COUNTY ~~WASCO~~ BENTON  
APPLICATION NO. GR-2610

OWNER: Frank X. Gallagher


MAILING ADDRESS: 1900 Beacon Drive

LOCATION OF WELL: Owner's No. \_\_\_\_\_

CITY AND STATE: Eugene, Oregon

SW 1/4 SW 1/4 Sec. 30 T. 14 ~~N.~~ 4 ~~E.~~ W., W.M.

Bearing and distance from section or subdivision corner 460' E. and 20' N.

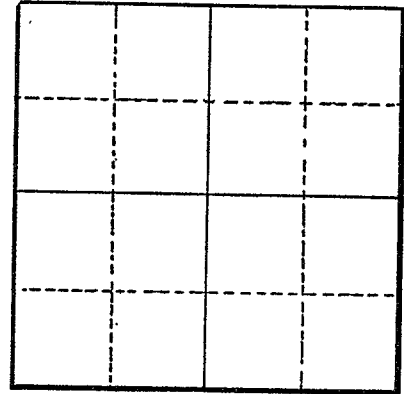

Section \_\_\_\_\_

Altitude at well \_\_\_\_\_

TYPE OF WELL: Drove Date Constructed 1939

Depth drilled 19 Depth cased 19

CASING RECORD:

- 1 - 3-inch
- 2 - 2-inch

FINISH:

Slotted from 16 to 19

AQUIFERS:

WATER LEVEL:

15-feet

PUMPING EQUIPMENT: Type Fairbanks Morse Centrifugal H.P. 10  
Capacity 260 G.P.M.

WELL TESTS:

Drawdown \_\_\_\_\_ ft. after \_\_\_\_\_ hours \_\_\_\_\_ G.P.M.

Drawdown \_\_\_\_\_ ft. after \_\_\_\_\_ hours \_\_\_\_\_ G.P.M.

USE OF WATER Irrigation Temp. \_\_\_\_\_ °F. \_\_\_\_\_, 19

SOURCE OF INFORMATION GR-2477

DRILLER or DIGGER \_\_\_\_\_

ADDITIONAL DATA:

Log \_\_\_\_\_ Water Level Measurements \_\_\_\_\_ Chemical Analysis \_\_\_\_\_ Aquifer Test \_\_\_\_\_

REMARKS: