

STATE ENGINEER
Salem, Oregon

Well Record

Bent
6620

STATE WELL NO. 14/4W-30P
COUNTY Benton
APPLICATION NO. GR-3004

OWNER: Lester E. & Marie A. Talbott


MAILING ADDRESS: Route 3

LOCATION OF WELL: Owner's No. 2

CITY AND STATE: Junction City, Oregon

SE $\frac{1}{4}$ SW $\frac{1}{4}$ Sec. 30 T. 14 N. S., R. 4 E. W., W.M.

Bearing and distance from section or subdivision corner N. 1095' E. 1595' of the S.W. corner

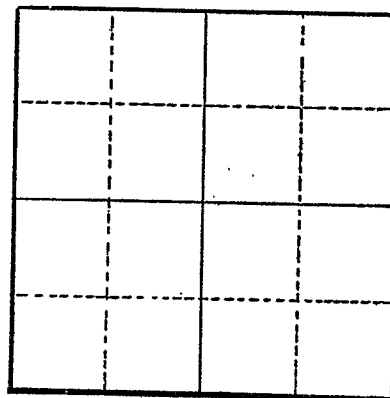

Section

Altitude at well

TYPE OF WELL: driven Date Constructed 1938

Depth drilled 24 Depth cased

CASING RECORD:

FINISH:

Standard perforation from 18 to 22

AQUIFERS:

WATER LEVEL:
12 feet

PUMPING EQUIPMENT: Type Berkeley Centrifugal H.P. 15
Capacity 525 G.P.M.

WELL TESTS:

Drawdown ft. after hours G.P.M.
Drawdown ft. after hours G.P.M.

USE OF WATER Irrigation Temp. °F., 19

SOURCE OF INFORMATION GR-2813

DRILLER or DIGGER

ADDITIONAL DATA:

Log Water Level Measurements Chemical Analysis Aquifer Test

REMARKS: