

STATE ENGINEER
Salem, Oregon

Well Record

*Bent
6621*

STATE WELL NO. 14/4W-30P
COUNTY LANE BENTON
APPLICATION NO. DR-26

OWNER: Frank X. Gallagher

MAILING ADDRESS: 1900 Beacon Drive


LOCATION OF WELL: Owner's No. _____

CITY AND STATE: Eugene, Oregon

SE 1/4 SW 1/4 Sec. 30 T. 14 ~~N.~~ S., R. 4 ~~E.~~ W., W.M.

Bearing and distance from section or subdivision

corner 1900' E. & 200' N.

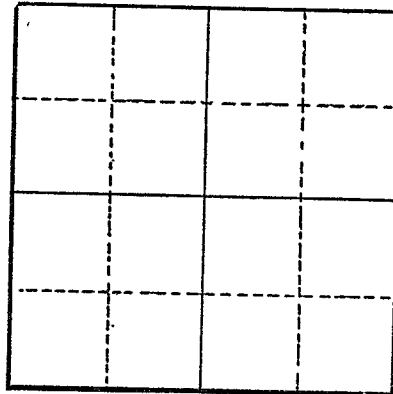

Section _____

Altitude at well _____

TYPE OF WELL: Drove Date Constructed 1937

Depth drilled 20 Depth cased 20

CASING RECORD:

4 - (2")

FINISH:

Slotted from 17 to 20

AQUIFERS:

WATER LEVEL:

15-feet

PUMPING EQUIPMENT: Type Allis Chalmer Centrifugal H.P. 10
Capacity 200 G.P.M.

WELL TESTS:

Drawdown _____ ft. after _____ hours _____ G.P.M.

Drawdown _____ ft. after _____ hours _____ G.P.M.

USE OF WATER Irrigation Temp. _____ °F. _____, 19____

SOURCE OF INFORMATION GR-2476

DRILLER or DIGGER Owner

ADDITIONAL DATA:

Log _____ Water Level Measurements _____ Chemical Analysis _____ Aquifer Test _____

REMARKS: