


Bent
6626

OWNER: Pinnell Bros. (Wesley & Robert Pinnell)
MAILING ADDRESS: Route 3
CITY AND STATE: Junction City, Oregon

LOCATION OF WELL: Owner's No. _____
NE 1/4 NW 1/4 Sec. 31 T. 14 S., R. 4 W., W.M.

Bearing and distance from section or subdivision corner 262' S., 40° W.

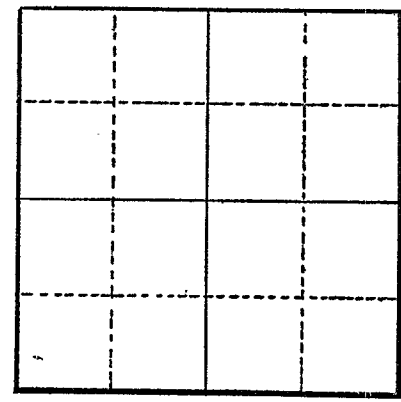

Section _____

Altitude at well _____

TYPE OF WELL: Drilled Date Constructed 1947

Depth drilled 24 Depth cased 24

CASING RECORD:

4-inch

FINISH:

Pipe 4' perforated - holes burned (by torch) 1/4" to 3/8" in size

AQUIFERS:

Sand & gravel

WATER LEVEL:

18-feet

PUMPING EQUIPMENT: Type _____ H.P. _____
Capacity _____ G.P.M.

WELL TESTS:

Drawdown 2 ft. after _____ hours Pumping 250 G.P.M.
Drawdown _____ ft. after _____ hours _____ G.P.M.

USE OF WATER Irrigation Temp. _____ °F. _____, 19

SOURCE OF INFORMATION GR-2374

DRILLER or DIGGER Frank Holloway, Monroe, Oregon

ADDITIONAL DATA:

Log Water Level Measurements _____ Chemical Analysis _____ Aquifer Test _____

REMARKS:

Sandy River bottom soil 8
Sand & Gravel 16