

STATE ENGINEER
Salem, Oregon

Well Record

STATE WELL NO. 14/4W-31D
COUNTY Benton
APPLICATION NO. GR-3023

OWNER: James R. and Mildred M. Crowson

MAILING ADDRESS: Route 3, Box 718

LOCATION OF WELL: Owner's No. _____

CITY AND STATE: Junction City, Oregon

NW 1/4 NW 1/4 Sec. 31 T. 14 S., R. 4 W., W.M.

Bearing and distance from section or subdivision
corner S. 34° 30' E., 995' from the common
corner of Sections 25, 30, 31, 36.

Altitude at well _____

TYPE OF WELL: drilled Date Constructed 1952

Depth drilled 30 Depth cased 24 feet
30 feet

CASING RECORD:

10 inches, steel
10 inches, slotted

FINISH:

Slotted from 24 to 30

AQUIFERS:

WATER LEVEL:
15 feet

PUMPING EQUIPMENT: Type Fairbanks Morse centrifugal H.P. 30
Capacity 600 G.P.M.

WELL TESTS:
Drawdown 2 1/2 ft. after _____ hours Pumping more than 600 G.P.M.
Drawdown _____ ft. after _____ hours _____ G.P.M.

USE OF WATER Irrigation Temp. _____ °F., 19.


SOURCE OF INFORMATION GR-2831

DRILLER or DIGGER Bill Hamilton, Albany, Oregon

ADDITIONAL DATA:

Log _____ Water Level Measurements _____ Chemical Analysis _____ Aquifer Test _____

REMARKS:

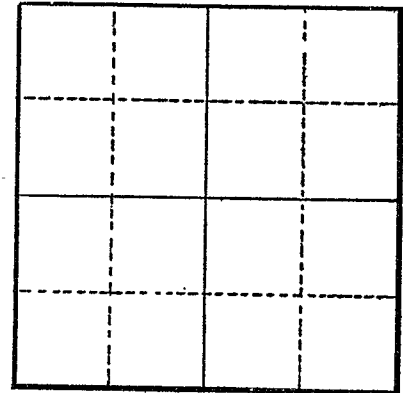

Section _____