

STATE ENGINEER
Salem, Oregon

Well Record

STATE WELL NO. 14/14-31E
COUNTY Benton
APPLICATION NO. CR-3761

OWNER: Edmond Crowson

MAILING

ADDRESS: Route 3, Box 691

CITY AND

STATE: Junction City, Oregon


LOCATION OF WELL: Owner's No. _____

Well #1

SW $\frac{1}{4}$ NW $\frac{1}{4}$ Sec. 31 T. 14 S., R. 4 W., W.M.

Bearing and distance from section or subdivision

corner 1022' E. and 722' N. from $\frac{1}{4}$ Cor. on W. of Sec. 31

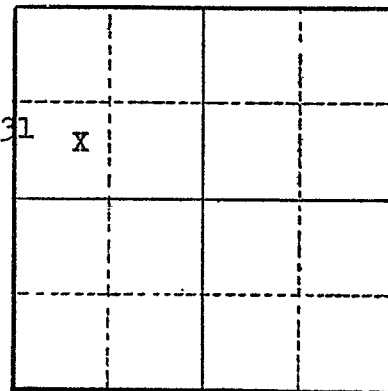

Section 31

Altitude at well _____

TYPE OF WELL: Driven Date Constructed April, 1952

Depth drilled 25 feet Depth cased 25 feet

CASING RECORD:

4 inch casing set to 25 feet

FINISH:

5 ft. perforated by torch 3/4" x 4" perforations

AQUIFERS:

WATER LEVEL:

12 feet below surface

PUMPING EQUIPMENT: Type Fairbanks Morse 3" H.P. 38
Capacity 400 G.P.M.

WELL TESTS:

Drawdown 2 ft. after _____ hours 400 G.P.M.

Drawdown _____ ft. after _____ hours _____ G.P.M.

USE OF WATER Irrigation Temp. _____ °F., 19 _____

SOURCE OF INFORMATION Well Registration Statement

DRILLER or DIGGER _____

ADDITIONAL DATA:

Log x Water Level Measurements _____ Chemical Analysis _____ Aquifer Test _____

REMARKS:

Log;

Willamette
Sand
Rock

Thickness	Depth to Bottom
10	25
6	
9	

3423