

STATE ENGINEER
Salem, Oregon

Well Record

STATE WELL NO. 14/4W-31E
COUNTY Benton
APPLICATION NO. GR-3024

OWNER: James R. and Mildred M. Crowson

MAILING ADDRESS: Route 3, Box 718

LOCATION OF WELL: Owner's No.

CITY AND STATE: Junction City, Oregon

SW 1/4 NW 1/4 Sec. 31 T. 14 N. 4 S., R. 4 W., W.M.

Bearing and distance from section or subdivision

corner Well located west 200' hence N. 17° 30'

W., 791' from property corner located

660' E. of SW Corner

Altitude at well

TYPE OF WELL: driven Date Constructed 1951

Depth drilled 21' Depth cased 16'

CASING RECORD:

5 inches steel
5 inches slotted

FINISH:

Slotted, sizes and number unknown, from 16 to 21

AQUIFERS:

WATER LEVEL:

PUMPING EQUIPMENT: Type Fairbanks Morse Centrifugal H.P. 25
Capacity 400 G.P.M.

WELL TESTS:

Drawdown 1 ft. after hours pumping 800 G.P.M.

Drawdown ft. after hours G.P.M.

USE OF WATER Irrigation Temp. °F. 19


SOURCE OF INFORMATION GR-2832

DRILLER or DIGGER Owner

ADDITIONAL DATA:

Log Water Level Measurements Chemical Analysis Aquifer Test

REMARKS:

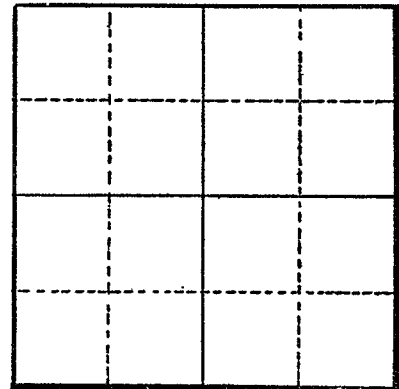

Section