

STATE ENGINEER  
Salem, Oregon


# Well Record

*Bank*  
*6631* STATE WELL NO. 14/4W-32P  
COUNTY Benton  
APPLICATION NO. GR-4043

OWNER: Dale Burgess MAILING ADDRESS: Route 1  
CITY AND STATE: Harrisburg, Oregon

LOCATION OF WELL: Owner's No. \_\_\_\_\_  
SE.  $\frac{1}{4}$  SW  $\frac{1}{4}$  Sec. 32 T. 14 S., R. 4 W., W.M.

Bearing and distance from section or subdivision  
corner N. 410.92' & #. 1806.24' from NW Cor. Sec. 5

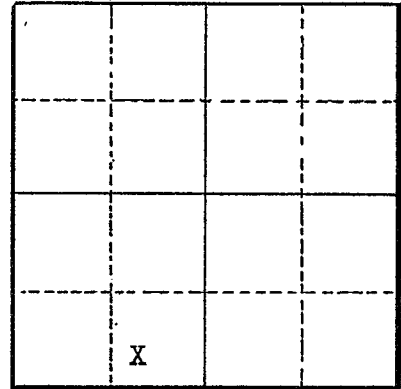

Section 32

Altitude at well \_\_\_\_\_

TYPE OF WELL: Driven Date Constructed 1942

Depth drilled 22 ft. Depth cased 22 ft.

### CASING RECORD:

4 inch well casing set to 22 feet

### FINISH:

Standard perforations from 18 to 22 feet

### AQUIFERS:

### WATER LEVEL:

12 feet below surface

PUMPING EQUIPMENT: Type Fairbanks Morse centrifugal 3" H.P. 20  
Capacity 400 G.P.M.

### WELL TESTS:

Drawdown \_\_\_\_\_ ft. after \_\_\_\_\_ hours \_\_\_\_\_ G.P.M.  
Drawdown \_\_\_\_\_ ft. after \_\_\_\_\_ hours \_\_\_\_\_ G.P.M.

USE OF WATER Irrigation Temp. \_\_\_\_\_ °F. \_\_\_\_\_, 19\_\_\_\_

SOURCE OF INFORMATION Well Registration Statement Cert. # GR-3644

DRILLER or DIGGER \_\_\_\_\_

### ADDITIONAL DATA:

Log  Water Level Measurements \_\_\_\_\_ Chemical Analysis \_\_\_\_\_ Aquifer Test \_\_\_\_\_

### REMARKS:

Log  
Top soil (loam) Thickness 5 Depth to Bottom 17  
Sand & gravel 17 0