

STATE ENGINEER  
Salem, Oregon

# Well Record


*Bent* STATE WELL NO. 14/5W-2D  
*6652* COUNTY BENTON  
APPLICATION NO. GR-2730

OWNER: Julius E. & Phyllis C. Purvine MAILING ADDRESS: Route 4

LOCATION OF WELL: Owner's No. \_\_\_\_\_ CITY AND STATE: Corvallis, Oregon

NW 1/4 NW 1/4 Sec. 2 T. 14 S. R. 5 W., W.M.

Bearing and distance from section or subdivision corner N. 58° 30' W. 975'

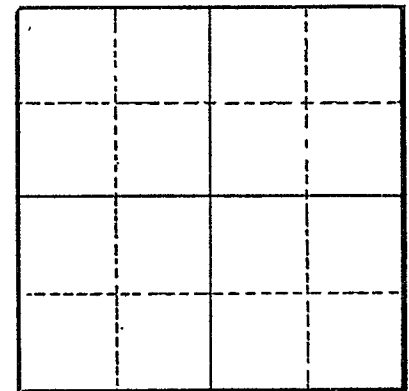

Section \_\_\_\_\_

Altitude at well \_\_\_\_\_

TYPE OF WELL: drilled Date Constructed 1949

Depth drilled 28 Depth cased 28

### CASING RECORD:

10-inch

### FINISH:

slotted, size and number unknown from 17 to 28

### AQUIFERS:

### WATER LEVEL:

10-feet

PUMPING EQUIPMENT: Type Centrifugal H.P. 50  
Capacity 700 G.P.M.

### WELL TESTS:

Drawdown no ft. after \_\_\_\_\_ hours Pumping 700 G.P.M.  
Drawdown \_\_\_\_\_ ft. after \_\_\_\_\_ hours \_\_\_\_\_ G.P.M.

USE OF WATER irrigation Temp. \_\_\_\_\_ °F., 19 \_\_\_\_\_

SOURCE OF INFORMATION GR-2583  
DRILLER or DIGGER Bill Hamilton

### ADDITIONAL DATA:

Log \_\_\_\_\_ Water Level Measurements \_\_\_\_\_ Chemical Analysis \_\_\_\_\_ Aquifer Test \_\_\_\_\_

### REMARKS: