

STATE ENGINEER  
Salem, Oregon

# Well Record

STATE WELL NO. 14/5W - 2H  
COUNTY BENTON  
APPLICATION NO. GR-1977

OWNER: I. P. and Lillian Crist


MAILING ADDRESS: Route 3

LOCATION OF WELL: Owner's No. \_\_\_\_\_

CITY AND STATE: Corvallis, Oregon

SE  $\frac{1}{4}$  NE  $\frac{1}{4}$  Sec. 2 T. 14 N. S., R. 5 E. W., W.M.

Bearing and distance from section or subdivision corner N 34° W. 764.0'

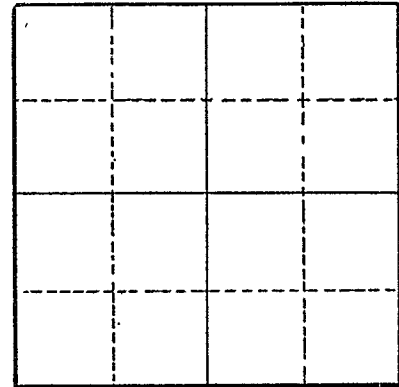

Section \_\_\_\_\_

Altitude at well \_\_\_\_\_

TYPE OF WELL: Drilled Date Constructed 1953

Depth drilled 32' Depth cased 32'

CASING RECORD:

10-inch

FINISH:

Number and kind unknown

AQUIFERS:

Loam and gravel

WATER LEVEL:

10-feet

PUMPING EQUIPMENT: Type Centrifugal 3x4 H.P. 20

Capacity 400 G.P.M.

WELL TESTS:

Drawdown 10 ft. after \_\_\_\_\_ hours Pumping 400 G.P.M.

Drawdown \_\_\_\_\_ ft. after \_\_\_\_\_ hours \_\_\_\_\_ G.P.M.

USE OF WATER Irrigation Temp. \_\_\_\_\_ °F., 19 \_\_\_\_\_

SOURCE OF INFORMATION GR-1908

DRILLER or DIGGER Gallatly and Schafer Philomath, Oregon

ADDITIONAL DATA:

Log  Water Level Measurements \_\_\_\_\_ Chemical Analysis \_\_\_\_\_ Aquifer Test \_\_\_\_\_

REMARKS:

Loam 10 to 10  
Gravel 22 to 32