


OWNER: Julius E. & Phyllis C. Purvine  
MAILING ADDRESS: Route 4  
CITY AND STATE: Corvallis, Oregon

LOCATION OF WELL: Owner's No. \_\_\_\_\_  
NE 1/4 NE 1/4 Sec. 3 T. 14 S., R. 5 W., W.M.  
Bearing and distance from section or subdivision corner N. 38' E. 930.5'

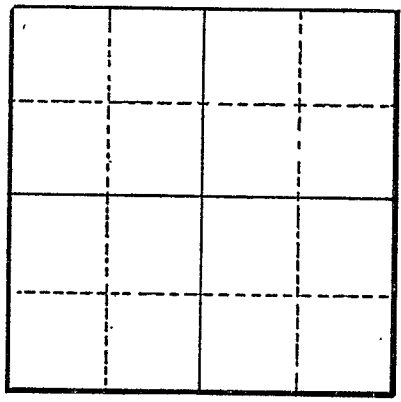

Section \_\_\_\_\_

Altitude at well \_\_\_\_\_

TYPE OF WELL: driven Date Constructed 1949  
Depth drilled 26 Depth cased 26

CASING RECORD:

10-inch

FINISH:

slotted, size and number unknown from 15 to 26

AQUIFERS:

WATER LEVEL:

15-feet

PUMPING EQUIPMENT: Type Centrifugal H.P. 50  
Capacity 650 G.P.M.

WELL TESTS:

Drawdown 10 ft. after \_\_\_\_\_ hours Pumping 650 G.P.M.  
Drawdown \_\_\_\_\_ ft. after \_\_\_\_\_ hours \_\_\_\_\_ G.P.M.

USE OF WATER irrigation Temp. \_\_\_\_\_ °F. \_\_\_\_\_, 19\_\_\_\_\_

SOURCE OF INFORMATION GR-2582  
DRILLER or DIGGER Bill Hamilton

ADDITIONAL DATA:

Log \_\_\_\_\_ Water Level Measurements \_\_\_\_\_ Chemical Analysis \_\_\_\_\_ Aquifer Test \_\_\_\_\_

REMARKS: