

STATE ENGINEER
Salem, Oregon

Well Record

Bent
6669 STATE WELL NO. 14/5W-3H
COUNTY Benton
APPLICATION NO. GR-4114

OWNER: E. L. Nixon & Bob Nixon

MAILING

ADDRESS: Route 3

LOCATION OF WELL: Owner's No. _____


CITY AND

STATE: Corvallis, Oregon

SE $\frac{1}{4}$ NE $\frac{1}{4}$ Sec. 3 T. 14 N. S., R. 5 E. W., W.M.

Bearing and distance from section or subdivision

corner N. 39° W. 694.2 ft. from $\frac{1}{4}$ Cor. between
Sec. 2 and 3

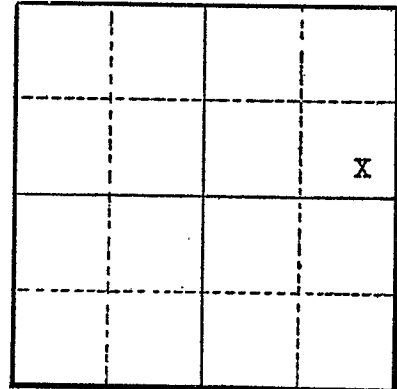

Section 3

Altitude at well _____

TYPE OF WELL: Drilled Date Constructed _____

Depth drilled 40 ft. Depth cased 40 ft.

CASING RECORD:

10 inch casing set to 40 feet

FINISH: _____

AQUIFERS: _____

WATER LEVEL: _____

15 feet below surface

PUMPING EQUIPMENT: Type Peerless centrifugal H.P. 5
Capacity _____ G.P.M.

WELL TESTS:

Drawdown 10 ft. after _____ hours 240 G.P.M.

Drawdown _____ ft. after _____ hours _____ G.P.M.

USE OF WATER Irrigation Temp. _____ °F. _____, 19

SOURCE OF INFORMATION Well Registration Statement Cert. # GR-3697

DRILLER or DIGGER _____

ADDITIONAL DATA:

Log _____ Water Level Measurements _____ Chemical Analysis _____ Aquifer Test _____

REMARKS: _____