

STATE ENGINEER  
Salem, Oregon

# Well Record

*3 bent*  
*6670*

STATE WELL NO. 14/5W-3J  
COUNTY BENTON  
APPLICATION NO. GR-2334

OWNER: Tune Rictor

MAILING ADDRESS: Rt. 3, Box 595


LOCATION OF WELL: Owner's No. \_\_\_\_\_

CITY AND STATE: Corvallis, Oregon

NE 1/4 SE 1/4 Sec. 3 T. 14 S., R. 5 W., W.M.

Bearing and distance from section or subdivision

corner S. 35° W. 478.6'

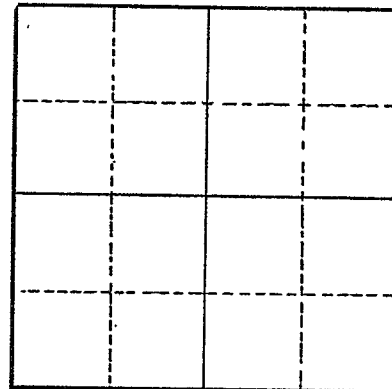

Section \_\_\_\_\_

Altitude at well \_\_\_\_\_

TYPE OF WELL: Drilled Date Constructed 1951

Depth drilled 31 Depth cased \_\_\_\_\_

### CASING RECORD:

5-inch

### FINISH:

Lower 5' notched with cutting torch

### AQUIFERS:

soil, loam and gravel

### WATER LEVEL:

13-feet

PUMPING EQUIPMENT: Type Fairbanks Morse

H.P. 5

Capacity 100 G.P.M.

### WELL TESTS:

Drawdown 1 ft. after \_\_\_\_\_ hours Pumping 100 G.P.M.

Drawdown \_\_\_\_\_ ft. after \_\_\_\_\_ hours \_\_\_\_\_ G.P.M.

USE OF WATER Irrigation Temp. \_\_\_\_\_ °F., 19\_\_\_\_

SOURCE OF INFORMATION GR-2220

DRILLER or DIGGER Frank Skillings, Corvallis Rt. 1, Oregon

### ADDITIONAL DATA:

Log  Water Level Measurements \_\_\_\_\_ Chemical Analysis \_\_\_\_\_ Aquifer Test \_\_\_\_\_

### REMARKS:

Chehallis soil 12" - 15"  
Sandy loam 3 1/2' - 4'  
Coarse sand and gravel 26'