

STATE ENGINEER
Salem, Oregon

Well Record

Bent
6696 STATE WELL NO. 14/5W-8G
COUNTY Benton
APPLICATION NO. GR-3699

OWNER: E. E. Zysett

MAILING
ADDRESS:

LOCATION OF WELL: Owner's No.


CITY AND
STATE:

Monroe, Oregon

SW $\frac{1}{4}$ NE $\frac{1}{4}$ Sec. 8 T. 14 ^{N.} S. 5 ^{E.} W., W.M.

Bearing and distance from section or subdivision

corner 2442' W. & 2046' S.

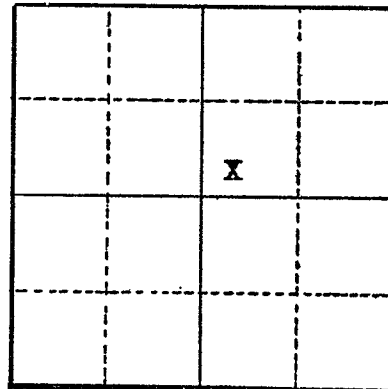

Section 8

Altitude at well

TYPE OF WELL: Drilled Date Constructed 1912

Depth drilled 35 feet Depth cased 35 feet

CASING RECORD:

4 inch casing set to 35 feet

FINISH:

6 inch 8x3" slot for seven feet from bottom up

AQUIFERS:

WATER LEVEL:

14 feet below surface

PUMPING EQUIPMENT: Type Centrifugal
Capacity 300 G.P.M.

H.P. 5

WELL TESTS:

Drawdown 4 ft. after 90 hours 90 G.P.M.

Drawdown 6 ft. after 80 hours 80 G.P.M.

USE OF WATER Irrigation Temp. 19 °F.

SOURCE OF INFORMATION Well Registration Statement

DRILLER or DIGGER

ADDITIONAL DATA:

Log X Water Level Measurements Chemical Analysis Aquifer Test

REMARKS:

Log:

Clay
Sand
Sand & gravel
Gravel

Thickness	Depth to Bottom
21	
4	
7	
3	35