

STATE ENGINEER
Salem, Oregon

Well Record

STATE WELL NO. 14/5W-10K(1)
COUNTY Benton
APPLICATION NO. GR-384

OWNER: Chris C. Lindseth

MAILING ADDRESS:


LOCATION OF WELL: Owner's No. #1

CITY AND STATE:

Junction City, Oregon

NE 1/4 SW 1/4 Sec. 10 T. 14 N. S., R. 5 W., W.M.

Bearing and distance from section or subdivision corner 795.5' North 0° 25' West of the SE corner of the N. half Aaron Richardson DLC #44

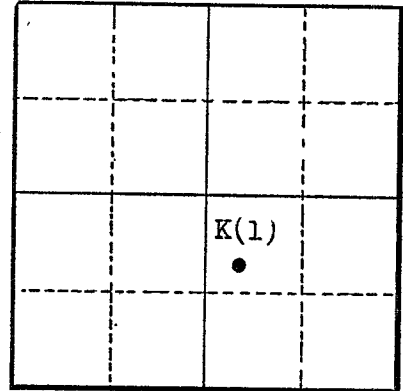

Section 10

Altitude at well 264' Interpolated

TYPE OF WELL: Drilled Date Constructed 2/13/55

Depth drilled 30 Depth cased 30

CASING RECORD:

10-inch heavy steel casing set from 0 to 30 feet.

FINISH:

8" x 1" slots six per foot set from 22 to 30 feet.

AQUIFERS:

unknown

WATER LEVEL:

15 feet below land surface 2/16/55

PUMPING EQUIPMENT: Type Rain O Flow centrifugal 4" H.P. 20
Capacity 600 G.P.M.

WELL TESTS:

Drawdown 2 ft. after hours pumping 500 G.P.M.
Drawdown 1.5 ft. after hours pumping 420 G.P.M.

USE OF WATER Irrigation 227.98 acres Temp. °F., 19

SOURCE OF INFORMATION Registration Statement GR-384

DRILLER or DIGGER Nickolas Klaus

ADDITIONAL DATA:

Log No. Water Level Measurements Chemical Analysis Aquifer Test

REMARKS: