

Well Record

Benton
STATE WELL NO. 14/5W-10-P
COUNTY Benton
6728 APPLICATION NO. GR-3963

OWNER: Keith L. Crocker


MAILING ADDRESS: Route 3, Box 617

LOCATION OF WELL: Owner's No. _____

CITY AND STATE: Junction City, Oregon

SE SW
NE 1/4 SE 1/4 Sec. 10 T. 14 S., R. 5 W., W.M.

Bearing and distance from section or subdivision corner 1800 feet East and 400 feet North
from the SW Corner, Section 10

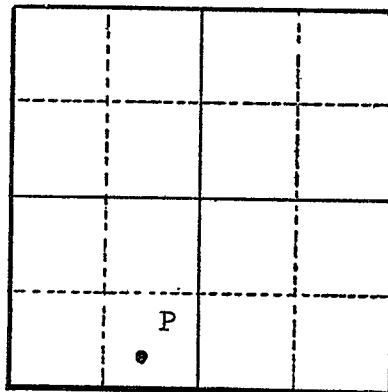

Section 10

Altitude at well 264 feet

TYPE OF WELL: Drilled Date Constructed 1947

Depth drilled 28 feet Depth cased 28 feet

CASING RECORD:

12 inch casing set from 0 to 28 feet

FINISH:

AQUIFERS:

dirt to gravel

WATER LEVEL:

14 feet

PUMPING EQUIPMENT: Type 3 x 4 Fairbanks Morse H.P. _____
Capacity _____ G.P.M.

WELL TESTS:

Drawdown 24 ft. after _____ hours 450 G.P.M.
Drawdown _____ ft. after _____ hours _____ G.P.M.

USE OF WATER Irrigation Temp. _____ °F., 19 _____

SOURCE OF INFORMATION GR-4134

DRILLER or DIGGER _____

ADDITIONAL DATA:

Log Water Level Measurements _____ Chemical Analysis _____ Aquifer Test _____

REMARKS:

dirt from surface to 18 ft
gravel from 18 ft to 28 ft