

STATE ENGINEER
Salem, Oregon

Well Record

Bent
6737 STATE WELL NO. 14/5W - 11G
COUNTY BENTON
APPLICATION NO. GR-2146

OWNER: C. E. Herron

MAILING ADDRESS: Route 3


LOCATION OF WELL: Owner's No. #244

CITY AND STATE: Junction City, Oregon

SW 1/4 NE 1/4 Sec. 11 T. 14 S., R. 5 W., W.M.

Bearing and distance from section or subdivision

corner 2650' S. 40° W.

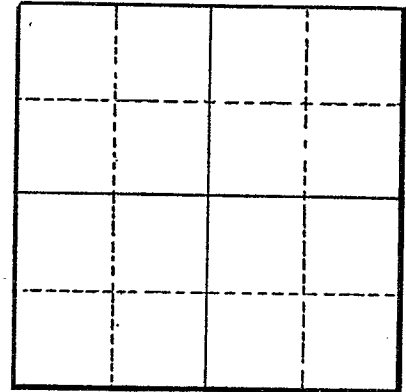

Section

Altitude at well

TYPE OF WELL: Drilled Date Constructed 1954

Depth drilled 23 Depth cased

CASING RECORD:

8-Inch.

FINISH:

AQUIFERS:

Soil, rock and sand.

WATER LEVEL:

9-Feet.

PUMPING EQUIPMENT: Type Fairbanks Morse.

H.P. 15

Capacity 325 G.P.M.

WELL TESTS:

Drawdown 1 ft. after hours Pumping 300 G.P.M.

Drawdown ft. after hours G.P.M.

USE OF WATER Irrigation

Temp. °F., 19

SOURCE OF INFORMATION GR-2058

DRILLER or DIGGER Oran Nye, Monroe, Oregon

ADDITIONAL DATA:

Log Water Level Measurements Chemical Analysis Aquifer Test

REMARKS:

Chehallis soil 6
Rock and sand 15