

STATE ENGINEER  
Salem, Oregon

# Well Record

Bent  
6759  
STATE WELL NO. 14/5W-127Q  
COUNTY Benton  
APPLICATION NO. GR-394

OWNER: Paul Rigor


MAILING ADDRESS: Rte Box 585

LOCATION OF WELL: Owner's No.

CITY AND STATE: Corvallis, Oregon

SW 1/4 SE 1/4 Sec. 12 T. 14 S., R. 5 W., W.M.

Bearing and distance from section or subdivision corner starting at SW cor of SW 1/4 of SE 1/4 of Sec 12 T 14S R5W

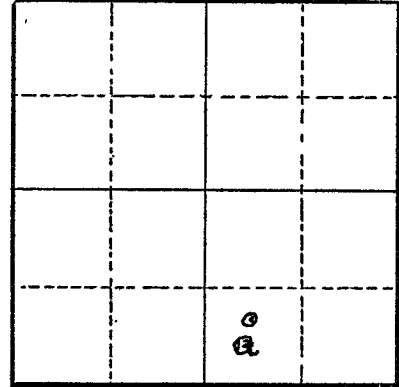

Section 12

Altitude at well

TYPE OF WELL: Drilled Date Constructed 1955

Depth drilled 25' Depth cased 25'

CASING RECORD:  
5-inch

FINISH:

AQUIFERS:

WATER LEVEL: 8'

PUMPING EQUIPMENT: Type Gardner Denver 3" outlet H.P. 35  
Capacity G.P.M.

WELL TESTS:  
Drawdown ft. after hours G.P.M.  
Drawdown ft. after hours G.P.M.

USE OF WATER Irrigation Temp. °F., 19

SOURCE OF INFORMATION GR-3969

DRILLER or DIGGER O. B. Nye

ADDITIONAL DATA:  
Log NA Water Level Measurements Chemical Analysis Aquifer Test

REMARKS: